


BASEMENT FLOOR PLAN

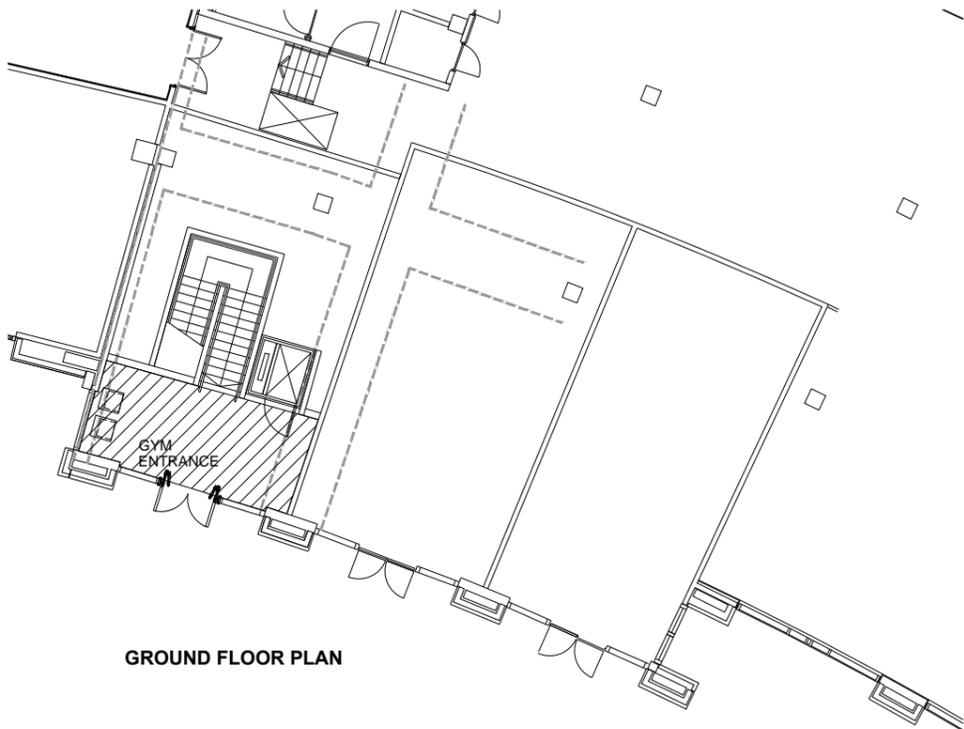

GROUND FLOOR PLAN

17.2m Denotes Escape Distance

MICHAEL HYDE AND ASSOCIATES LIMITED
chartered architects



MANCHESTER ■ SHEFFIELD □

51 BARTON ARCADE
 DEANS GATE
 MANCHESTER M3 2BJ
 TEL 0161 834 1018
 FAX 0161 834 4798
 Manchester@MHA
 architects.com

ALLIANCE HOUSE
 LEOPOLD STREET
 SHEFFIELD S1 2GY
 TEL 0114 2759666
 FAX 0114 2757751
 Sheffield@MHA
 architects.com

REV	DATE	DESCRIPTION	DRN	CHK
G	07.07.14	DRAWING UPDATED TO REFLECT AS BUILT	GL	HM
F	24.02.14	STORE ROOM, PT ROOM AND STAFF ROOM ARRANGEMENT AMENDED, ADDITIONAL PLANT ROOM ADDED	CW	HM
E	14.01.14	DRAWING UPDATED FOLLOWING COMMENTS FROM THE CONTRACTOR	CW	HM
D	08.01.14	DRAWING UPDATED FOLLOWING COMMENTS FROM THE WARRANT OFFICER	CW	HM
C	09.12.13	NUMBER OF WHB INCREASED TO MALE CHANGE	CW	HM
B	03.12.13	ESCAPE TRAVEL DISTANCES FROM GYM FLOOR AREAS ADDED	CW	HM
A	29.11.13	TIMBER STUD WALL ADDED TO CLOSE VOID AND SUPPORT STAIR	GG	HM

PROJECT TITLE		
PURE GYM LTD EXCHANGE CRESCENT, EDINBURGH		
DRAWING TITLE		
GROUND & BASEMENT FLOOR FIRE EVACUATION PLAN		
DRAWN / CHECKED	DATE	SCALE
CW/HM	NOV '13	1:250@A3
JOB No	DRAWING	REVISIONS
1PG01-333	2-600	G